





BAY #1 & 2, 1925 - 39 AVENUE NE
CALGARY, ALBERTA
MEASURED - MARCH 28, 2005

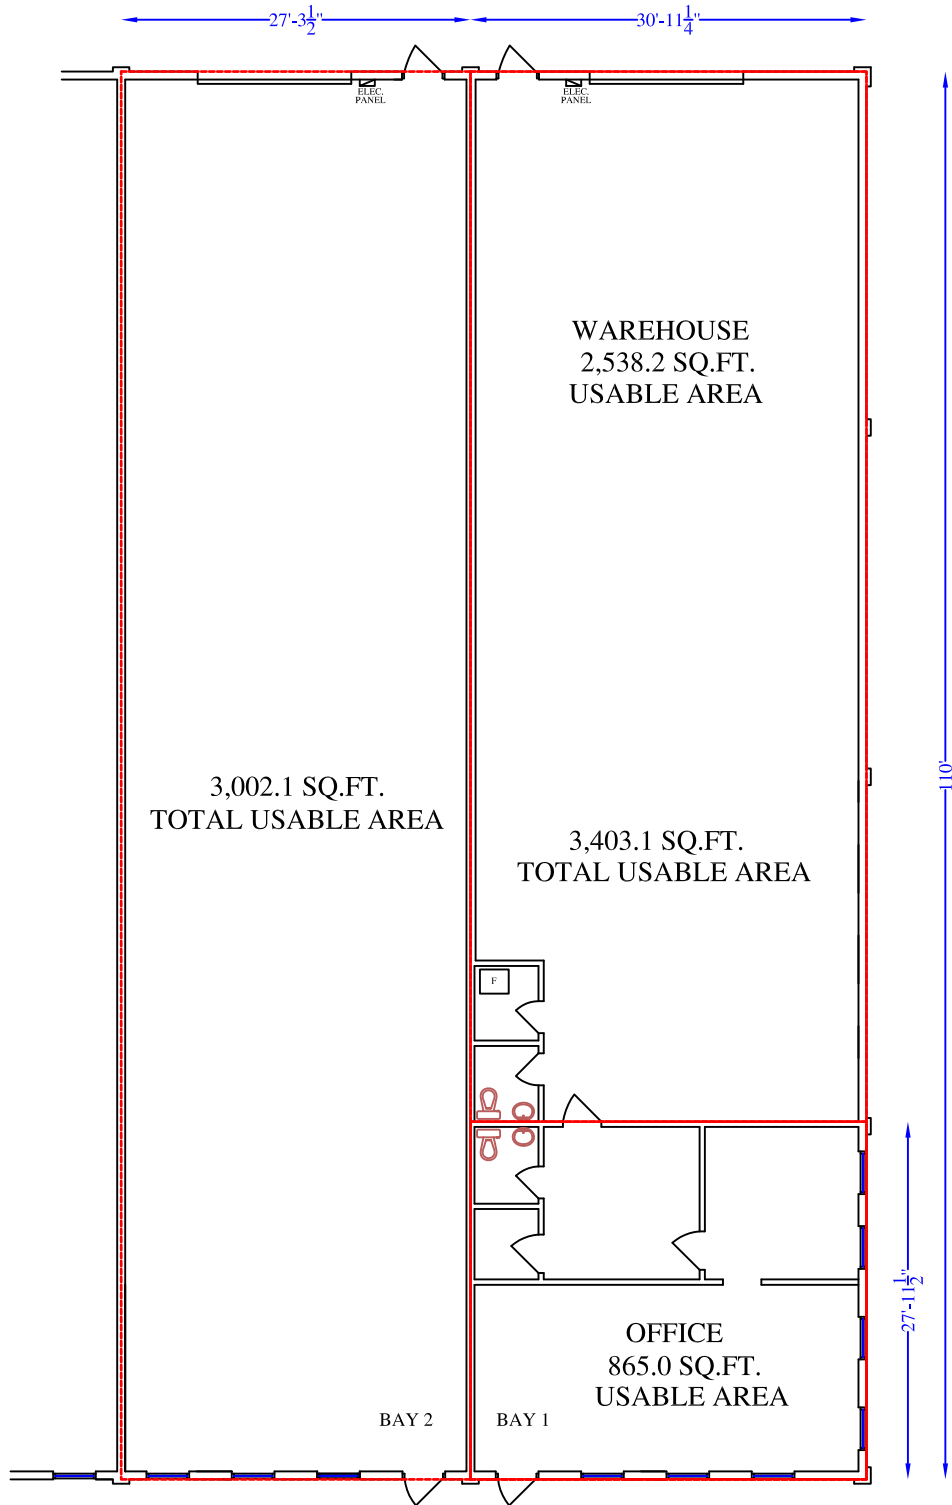

MEASURE MASTERS™
CALGARY
(403)238-3555

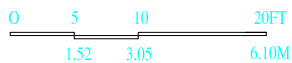

SAFEWAY HOLDINGS (ALBERTA) LTD.
CALGARY, ALBERTA, T2P 3H6
(403) 291-3199/269-9885